

EXHIBIT Q

BEST AVAILABLE COPY

Fric

Suzanne Ivan
S.S.#

981222

1ST AVAILABLE COPY

RMJ

New Job

FAX TRANSMITTAL

RMJ FAX: (415)871-2459

Total Pages Being Sent, Including Cover Sheet: 1 ② 3 4 5 6

Date: 8-11-98

Time: PM

TO: Firm: MBR

Fax #: (415)389-0578

Attn: Art Richardson

Original Mailed: Yes () No (✓)

Project: Sheraton Inn

RMJ Job #: 37276R

Please notify the sender at (415) 871-2282 if the faxed copy is incomplete or unclear.

We are sending to you:

The following:

☒ For your use ☐ As requested by you☐ Memo☐ Agreement☐ Letter☐ Plans, Sections, or Details☐ For review and comment☐ Calculations☐ Specifications☐ Shop Drawings☒ Other

Description and Remarks:

1 Copy of Required Tie Down Capacities

Art,

Please provide calcs. & shop drawings for the attached seven types of tie-downs. Please incorporate the shrinkage compensating washer where and as necessary

Thanks
Brian

BY B. Fischer

DISTRIBUTION:

| | | | |
|-------------------------------------|---------|--|---------|
| <input type="checkbox"/> Contractor | Fax No. | <input type="checkbox"/> Owner/Developer | Fax No. |
| <input type="checkbox"/> Architect | Fax No. | <input type="checkbox"/> | Fax No. |

RMJRobinson
Meier
Jully & Associates

Structural Engineers

103 Linden Avenue
So. San Francisco, CA 94080
650 871-2282 FAX 650 871-2459S.S.F., CAJob No. 97276Date 8/98Signed by BLF

Sheet No. of

TIE DOWN CAPACITY

| | Level 1 | Level 2 | Level 3 | Level 4 |
|---|---------|---------|---------|---------|
| 2 | 31,000 | 20,000 | 10,500 | 3,500 |
| 3 | 18,500 | 13,000 | 8,000 | 2,900 |
| 4 | 13,600 | 7,500 | 2,500 | |
| 5 | 20,500 | 12,500 | 5,000 | |
| 6 | 4,200 | 1,500 | | |
| 7 | 1,200 | | | |
| 1 | 33,500 | 25,000 | 16,000 | 8,000 |

STUDS SHALL BE 3X4 AT LEVELS 1 & 2
AND 2X4 AT LEVELS 3 & 4.

Anchor Tiedown Systems, Inc.

205 Camino Alto #135
P.O. Box 2517
Mill Valley, CA 94941

(415) 389-0576
Fax (415) 389-0578



FACSIMILE COVER SHEET

DATE: Sept 16, 1998

TIME: _____

TOTAL PAGES (Inc. this page): 9

TO:

Joe / SHAW

Bolin Custom Bldg

FAX #: 530-877-2534

PHONE #: _____

SUBJECT: University Village

98118

MESSAGE:

Please review and call me

Thanks

These need to be approved by
Dominic Chr. Show will be made part
of the structural Draw

Anchor age Details to follow
Draw of AB shown


BY:

Kew Boilen

cc 916-771-7919

U.V

98118

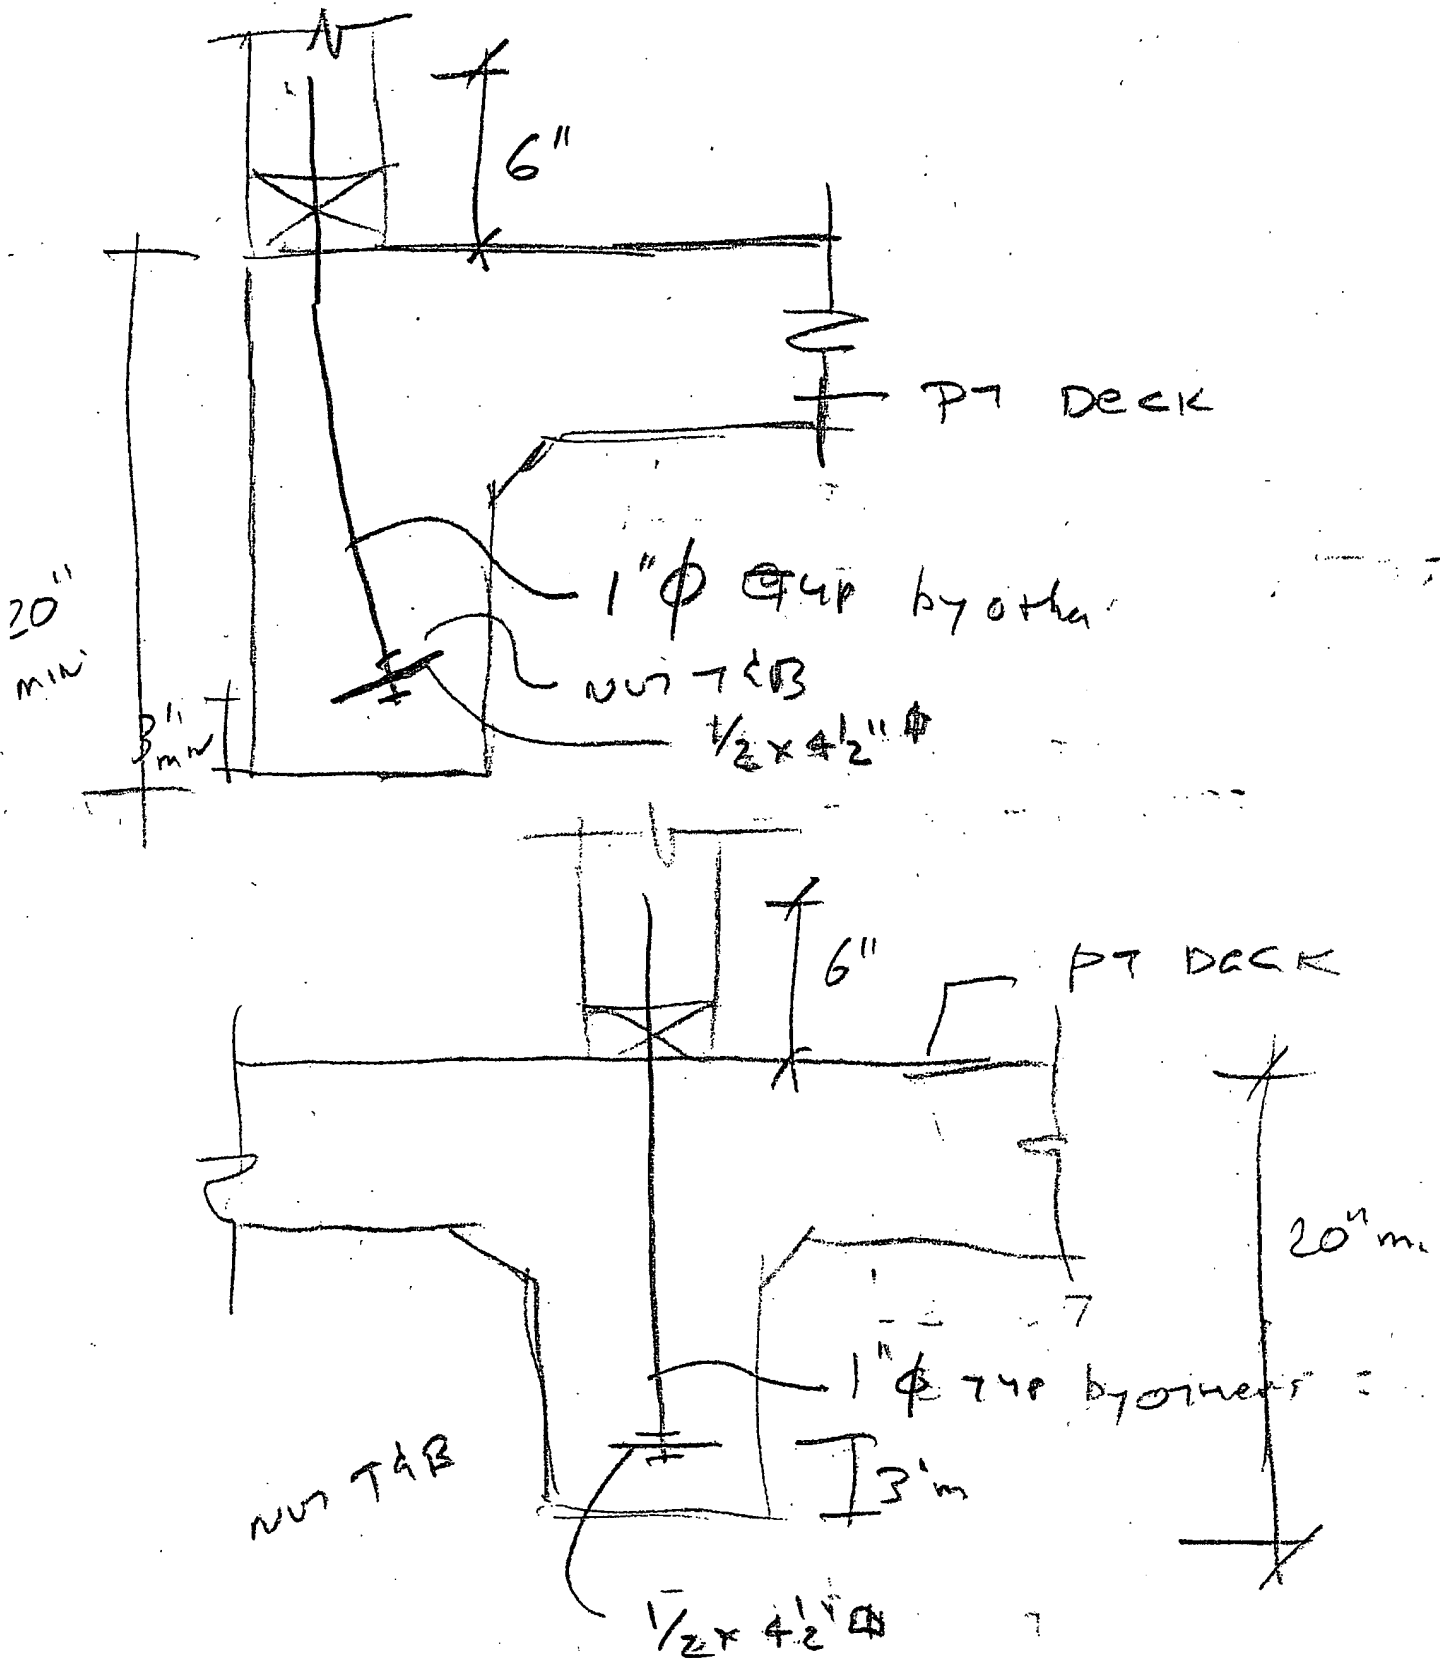

SEE PT STRUCT DWG FOR ADDITIONAL
REINFORCING & DETAILS.

Anchor Tiedown Systems, Inc.

205 Camino Alto #135
P.O. Box 2517
Mill Valley, CA 94941

(415) 389-0576
Fax (415) 389-0578



FACSIMILE COVER SHEET

DATE: SEP 16, 1998

TIME: _____

TOTAL PAGES (Inc. this page): 4

TO: _____

ART

FAX #: 650-578-0240

PHONE #: 650-578-9899

SUBJECT: UNIVERSITY VILLAGE

MESSAGE: _____

Please review and call me


WE CAN THEN CREATE THE FINAL
SHEET

Thanks

BY: _____

Ken

Level 1 (ST) 12570 #

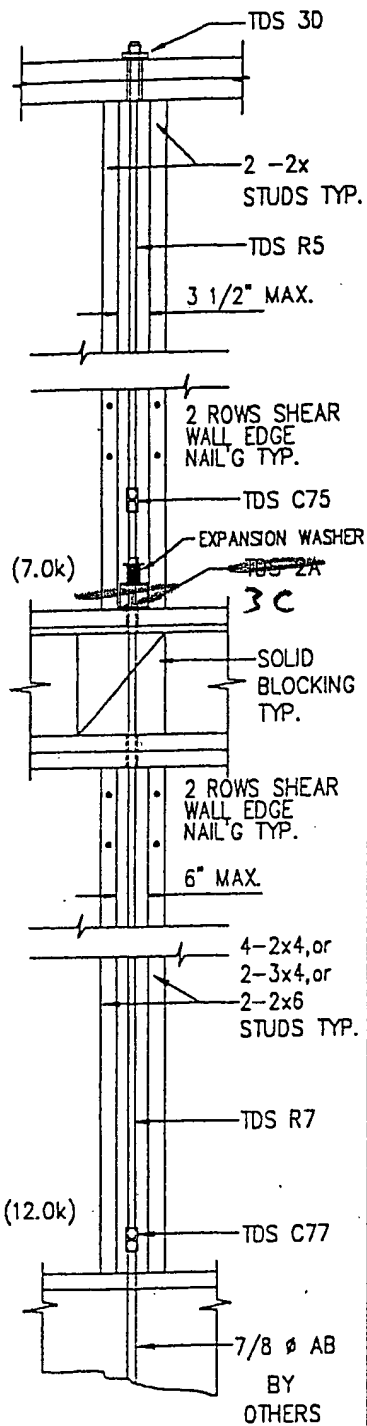


SEE STRUCTURAL DWGS.
FOR EMBEDMENT DETAILS.

3D 2A (57)

TWO LEVEL

L 1 (L) 18670 #

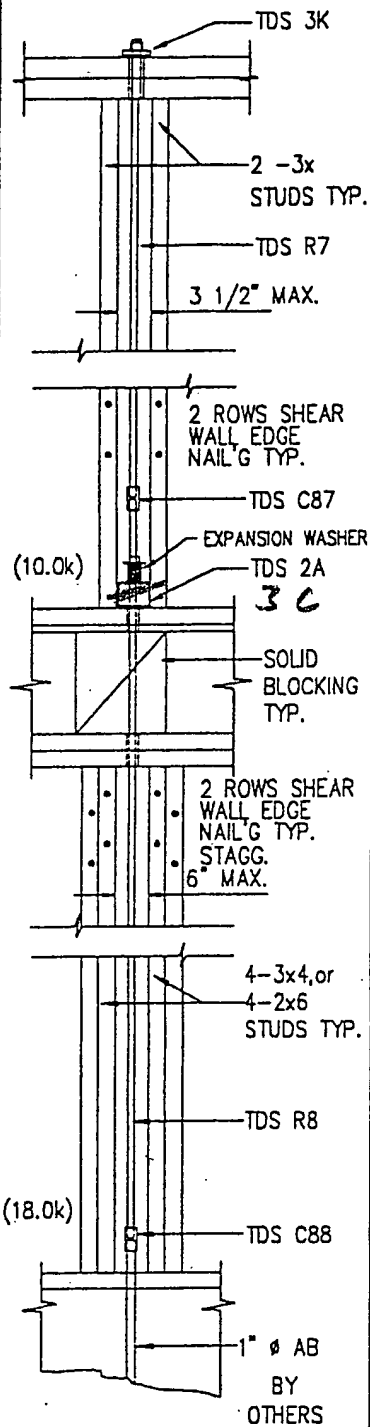


SEE STRUCTURAL DWGS.
FOR EMBEDMENT DETAILS.

3K 2A (78)

TWO LEVEL

Level 1 (R) 11780 #

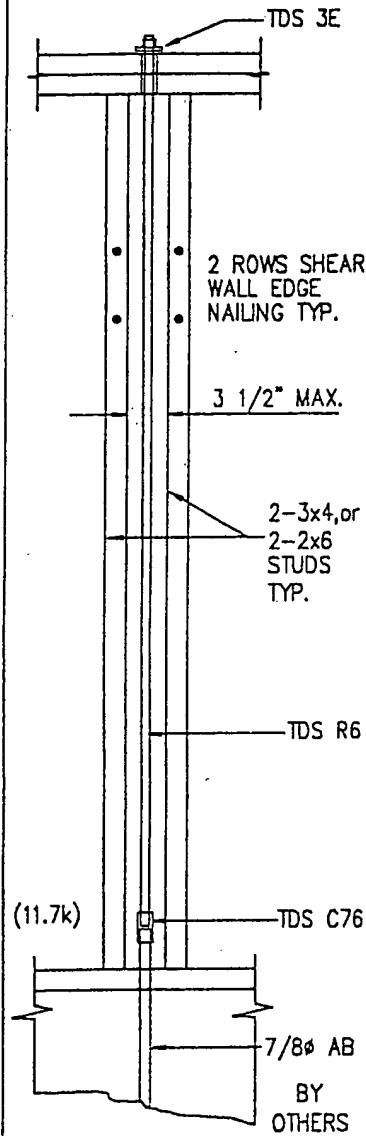


SEE STRUCTURAL DWGS.
FOR EMBEDMENT DETAILS.

3E (6)

ONE LEVEL

ALL 3c w/1'16"φ


Level 1 (R) 5230 #

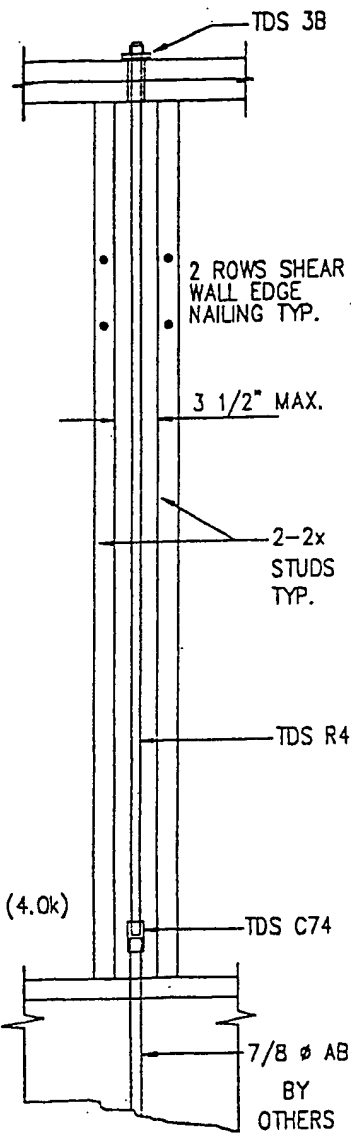

SEE STRUCTURAL DWGS. FOR EMBEDMENT DETAILS.

3B (4)

X
ONE LEVEL

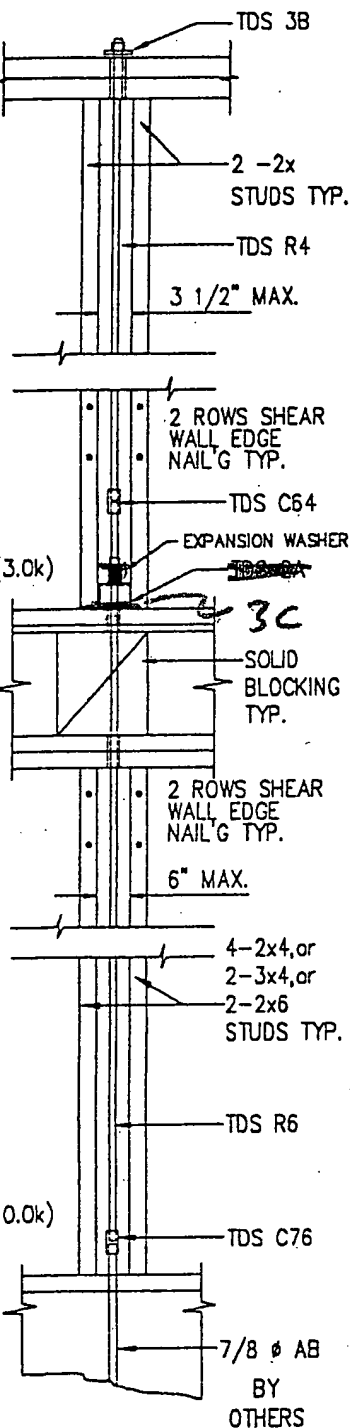


SEE STRUCTURAL DWGS. FOR EMBEDMENT DETAILS.

3B 2A (46)

◆
TWO LEVEL

Level 1 (R) 5230 #
Lev 1 (L) 11330 #
Level 1 (L) 18380 #

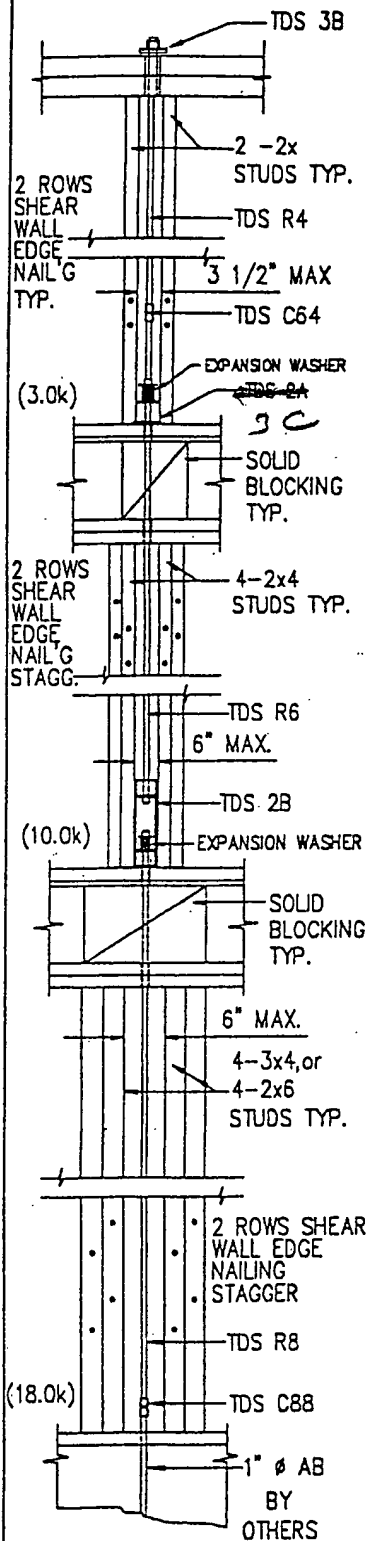

SEE STRUCTURAL DWGS. FOR EMBEDMENT DETAILS.

3B 2A 2B (468)

◆ ◆ ◆
THREE LEVEL


SHERATON INN

SOUTH SAN FRANCISCO, CALIFORNIA

MBR JOB #98122

VOID

Level 4 (RODS) 10 #
 Level 3 (RODS) 16 #
 Level 2 (L) 30460 #
 Level 1 (STUDS) 36090 #

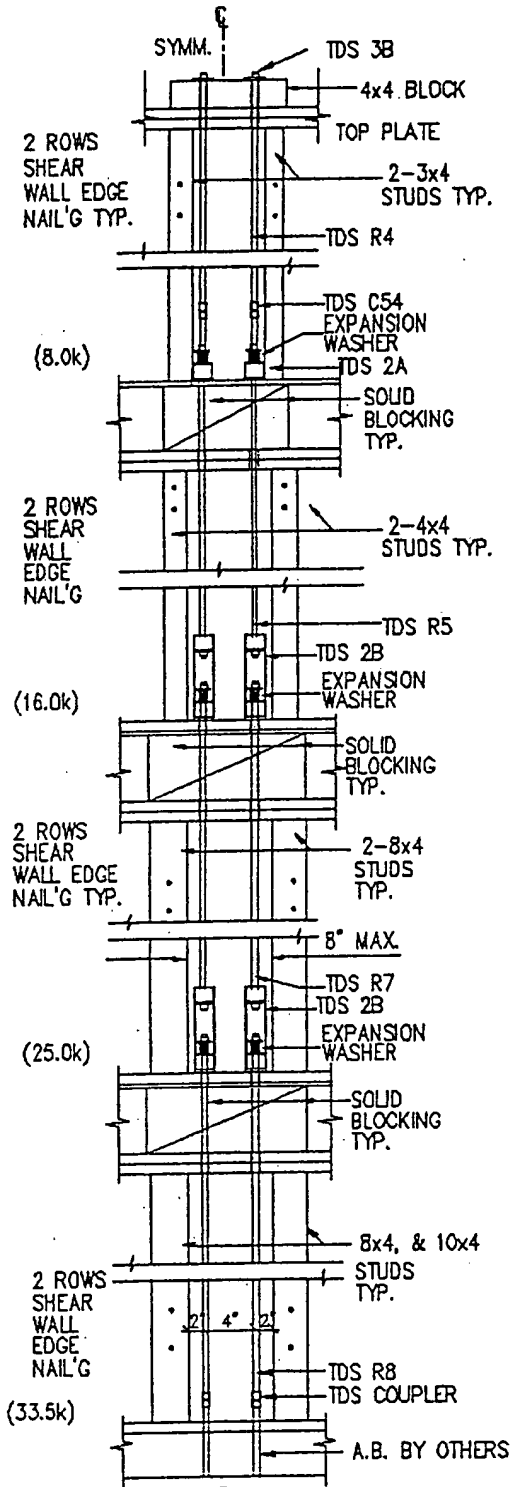


3B 2A 2B 2B (4578)

3B 2A 2B 2B (4578)

1

Level 4 (R) #
 Level 3 (L) #
 Level 2 (L) 23450 #
 Level 1 (ST) 31710 #

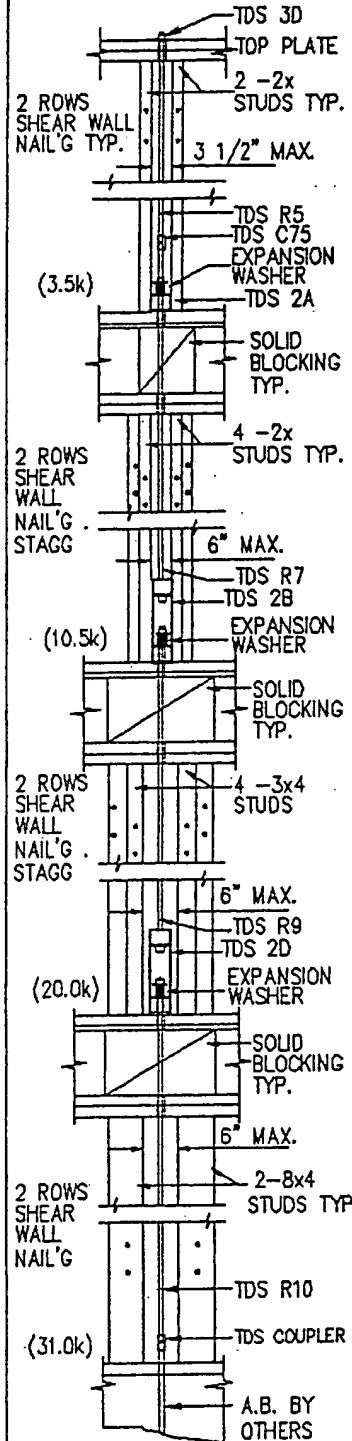


A.B.'S PER STRUCTURAL DWGS.

3D 2A 2D 2D (5,7,9,10)

2

Level 4 (R) 5230 #
 Level 3 (R) 8180 #
 Level 2 (L) 15230 #
 Level 1 (R) 20940 #

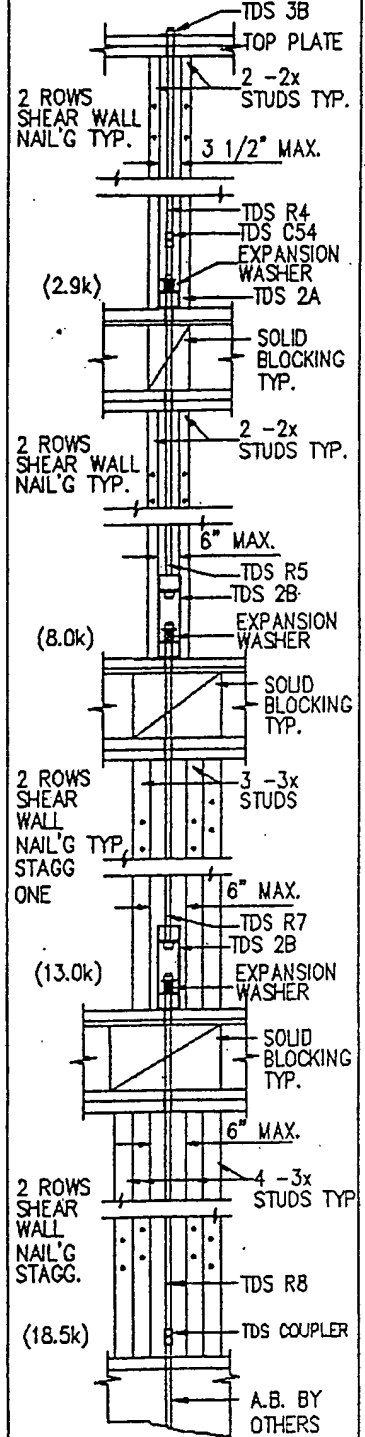

A.B.'S PER STRUCTURAL DWGS.

3B 2A 2B 2B (4578)

3

Level 3 (R) 5230 #

Level 2 (R) 8180 #

Level 1 (L) 15230 #

TDS 3B
 2 -2x STUDS TYP.
 TDS R4
 3 1/2" MAX
 TDS C54
 EXPANSION WASHER
 (2.5k) TDS 2A
 SOLID BLOCKING TYP.
 2-3x4 STUDS TYP.
 2 ROWS SHEAR WALL EDGE NAIL'G
 TDS R5
 6" MAX.
 TDS 2B
 EXPANSION WASHER
 (7.5k)
 SOLID BLOCKING TYP.
 6" MAX.
 4 -3x STUDS TYP.
 2 ROWS SHEAR WALL EDGE NAILING STAGGER
 TDS R7
 (13.6k) TDS COUPLER
 A.B. BY OTHERS
 A.B.'S PER STRUCTURAL DWGS. TYP.
 3B 2A 2B (457)

4

Level (R) 8180 #

Level (ST) 12570 #

Level 1 (R) 20940 #

TDS 3D
 2 -2x STUDS TYP.
 TDS R5
 3 1/2" MAX
 TDS C75
 EXPANSION WASHER
 (5.0k) TDS 2A
 SOLID BLOCKING TYP.
 2 ROWS SHEAR WALL EDGE NAIL'G
 2-3x STUDS TYP.
 TDS R7
 6" MAX.
 TDS 2C
 EXPANSION WASHER
 (12.5k)
 SOLID BLOCKING TYP.
 6" MAX.
 4 -3x STUDS TYP.
 2 ROWS SHEAR WALL EDGE NAILING STAGGER
 TDS R8
 (20.5k) TDS COUPLER
 A.B. BY OTHERS
 A.B.'S PER STRUCTURAL DWGS. TYP.
 3D 2A 2C (578)

5

Level 2 (R) #

Level 1 (R) 5230 #

TDS 3B
 2 -2x STUDS TYP.
 TDS R4
 3 1/2" MAX.
 2 ROWS SHEAR WALL EDGE NAIL'G TYP.
 TDS C44
 EXPANSION WASHER
 (1.5k) TDS 2A
 SOLID BLOCKING TYP.
 2 ROWS SHEAR WALL EDGE NAIL'G TYP.
 6" MAX.
 2-3x STUDS TYP.
 TDS R4
 (4.2k) TDS COUPLER
 A.B. BY OTHERS
 A.B.'S PER STRUCTURAL DWGS.
 3B 2A (44)

6

Level 1 (R) 5230 #

TDS 3B
 2 ROWS SHEAR WALL EDGE NAILING TYP.
 3 1/2" MAX.
 2-2x STUDS TYP.
 TDS R4
 (1.2k) TDS COUPLER
 A.B. BY OTHERS
 A.B.'S PER STRUCTURAL DWGS.
 3B (4)

7

Calculations Table.

PROJECT NAME Station Inn



6.4


9D2A 2C (578)

3B2A(44)

3P3 (4)

S. SAN FRANCISCO

Calculations Table

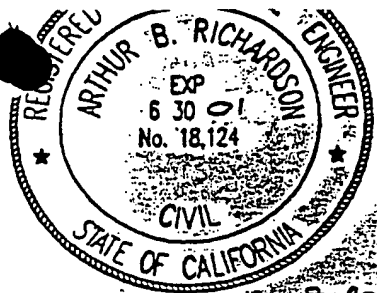PROJECT NO. 98122PROJECT NAME SHERATON INN

8.20.98

| LEVEL | TDS MODEL | TDS VALUE | TDS ROD | Σ TDS ± VAL | FRAME VALUE | CONTRL VALUE | HD VALUE | HD |
|-------|-----------|-----------|---------|----------------|----------------|-----------------|-------------|----|
| 4TH | 2x3B | 11.26 | | | | 10.46 | 8.00 | |
| | 2x2A | | 10.46 | | 12.57 | | | |
| | 2-3x4 | | | | | | | |
| 3RD | 2x2A | 12.20 | | 22.66 | | | | |
| | 2x2B | | 16.36 | | 16.95 | 16.36 | 16.00 | |
| | 2x4x4 | | | | | | | |
| 2ND | 2x2B | 14.10 | | 30.46 | | 30.46 | | |
| | 2x27 | | 32.06 | | 31.71 | | 25.00 | |
| | 2-8x4 | | | | | | | |
| 1ST | 2x2B | 14.10 | | 44.56 | | | | |
| | 2x2B | | 41.88 | | 36.09 | 36.09 | 33.50 | |
| | 3x4+10x4 | | | | | | | |
| 4TH | 3D | 10.35 | | | | | | |
| | 25 | | 8.18 | | 8.20 | 8.18 | 3.50 | |
| | 2-2x4 | | | | | | | |
| 3RD | 2A | 6.10 | | 14.28 | | 14.28 | | |
| | 27 | | 16.03 | | 14.76 | | 10.50 | |
| | 4-2x4 | | | | | | | |
| 2ND | 20 | 9.17 | | 23.45 | | 23.45 | | |
| | 29 | | 26.50 | | 23.51 | | 20.00 | |
| | 4-3x4 | | | | | | | |
| 1ST | 2D | 9.17 | | 32.62 | | | | |
| | 26 | | 32.72 | | 31.71 | 31.71 | 31.00 | |
| | 2-8x4 | | | | | | | |
| 4TH | 3B | 5.63 | | | | | | |
| | 24 | | 5.23 | | 8.20 | 5.23 | 2.90 | |
| | 2-2x4 | | | | | | | |
| 3RD | 2A | 6.10 | | 11.33 | | | | |
| | 2B | | 8.18 | | 8.20 | 8.18 | 8.00 | |
| | 2-2x4 | | | | | | | |
| 2ND | 2B | 7.05 | | 15.23 | | 15.23 | | |
| | 27 | | 16.03 | | 18.04 | | 13.00 | |
| | 3-3x4 | | | | | | | |
| 1ST | 2B | 7.05 | | 22.28 | | 20.94 | 18.5 | |
| | 28 | | 20.94 | | 23.51 | | | |
| | 4-3x4 | | | | | | | |
| 3RD | 3B | 5.63 | | | | | | |
| | 24 | | 5.23 | | 8.20 | 5.23 | 2.50 | |
| | 2-2x4 | | | | | | | |
| 2ND | 2A | 6.10 | | 11.33 | | | | |
| | 25 | | 8.18 | | 12.57 | 8.18 | 7.50 | |
| | 2-3x4 | | | | | | | |
| 1ST | 2B | 7.05 | | 15.23 | | 15.23 | | |
| | 27 | | 16.03 | | 23.51 | | 13.60 | |
| | 4-3x4 | | | | | | | |

(OAL 5)

RODS 4" CC
STUBS 8" CLR
4x4 BULK ON TOP

OAL [3A2A2B2B
(4578)

2

3D2A2D2D (57910)

3

3A2A2B2B (4578)

4

3A2A2B (457)

RMJRobinson
Meier
Jully & Associates

Structural Engineers

103 Linden Avenue
So. San Francisco, CA 94080
650 871-2282 FAX 650 871-2459S.S.F., CAJob No. 97276Date 8/98Signed by BLFSheet No. of TIE DOWN CAPACITY

| | Level 1 | Level 2 | Level 3 | Level 4 |
|---|---------|---------|---------|---------|
| 2 | 31,000 | 20,000 | 10,500 | 3,500 |
| 3 | 18,500 | 13,000 | 8,000 | 2,900 |
| 4 | 13,600 | 7,500 | 2,500 | |
| 5 | 20,500 | 12,500 | 5,000 | |
| 6 | 4,200 | 1,500 | | |
| 7 | 1,200 | | | |
| 1 | 33,500 | 25,000 | 16,000 | 8,000 |

STUDS SHALL BE 3X4 AT LEVELS 1 & 2
AND 2X4 AT LEVELS 3 & 4.

SHERATON INTL

SOUTH SAN FRANCISCO, CALIFORNIA

MBR JOB #98122

10.1.98 plnd - pls MAKE CORRECTIONS
TO PARTS LIST AS SHOWN

Pricing

+
WASHERS

FOUR STORY

DOP 9.30.98

ENGR: RMJ.

650-871-2282

EX 871-2459

SHOWN

QTY

1

16

96

2

20

60

3

48

134

4

40

80

5

36

160

6

20

3B 2A (47)

20

7

12

0

7

WB

4

W)

3B 2A (47) 3B


BOTT.

0

570

| Components | UNIT\$ | UNIT TOTAL | \$SUM | "1" | TTL | "2" | TTL | "3" | TTL | "4" | TTL | "5" | TTL | "6" | TTL | "7" | TTL | "7WB" | TTL |
|---------------|--------|------------|--------|-----|-----|-----|-----|-----|-----|-----|-----|-----|-----|-----|-----|-----|-----|-------|-----|
| Run Totals--> | | | | | | | | | | | | | | | | | | | |
| A36 10' R10 | 18.29 | 212 | 8788.3 | | 32 | | 20 | | 48 | | 40 | | 36 | | 20 | | 12 | | 4 |
| A36 10' R9 | 12.69 | 20 | 365.8 | | | 1 | 20 | | | | | | | | | | | | |
| A36 10' R8 | 8.64 | 116 | 1002.2 | 1 | 32 | | 1 | 48 | | 1 | 36 | | 1 | 36 | | | | | |
| A36 10' R7 | 7.02 | 196 | 1375.9 | 1 | 32 | 1 | 20 | 1 | 48 | 1 | 40 | 1 | 36 | 1 | 20 | | | | |
| A36 10' R5 | 3.08 | 176 | 542.08 | 1 | 32 | 1 | 20 | 1 | 48 | 1 | 40 | 1 | 36 | | | | | | |
| A36 10' R4 | 1.84 | 156 | 287.04 | 1 | 32 | | | 1 | 48 | 1 | 40 | | | 1 | 20 | 1 | 12 | 1 | 4 |
| A36 N10 | 0.6 | 20 | 12 | | | 1 | 20 | | | | | | | | | | | | |
| A36 N9 | 0.25 | 40 | 10 | | | 2 | 40 | | | | | | | | | | | | |
| A36 N8 | 0.17 | 116 | 19.72 | 1 | 32 | | | 1 | 48 | | | | 1 | 36 | | | | | |
| A36 N7 | 0.14 | 332 | 46.48 | 2 | 64 | 2 | 40 | 2 | 96 | 1 | 40 | 2 | 72 | 1 | 20 | | | | |
| A36 N5 | 0.06 | 296 | 17.76 | 2 | 64 | 1 | 20 | 2 | 96 | 2 | 80 | 1 | 36 | | | | | | |
| A36 N4 | 0.03 | 160 | 4.8 | 1 | 32 | | | 1 | 48 | 1 | 40 | | | 1 | 20 | 1 | 12 | 2 | 8 |
| PW8 | 0.75 | 116 | 87 | 1 | 32 | | | 1 | 48 | | | | 1 | 36 | | | | | |
| PW7 | 0.75 | 312 | 234 | 2 | 64 | 1 | 20 | 2 | 96 | 1 | 40 | 2 | 72 | 1 | 20 | | | | |
| PW5 | 0.75 | 240 | 180 | 2 | 64 | | | 2 | 96 | 2 | 80 | | | | | | | | |
| DW10 | 1.1 | 20 | 22 | | | | 1 | 20 | | | | | | | | | | | |
| DW9 | 1.1 | 40 | 44 | | | | 2 | 40 | | | | | | | | | | | |
| DW7 | 1.1 | 20 | 22 | | | | 1 | 20 | | | | | | | | | | | |
| 2A | 3.88 | 196 | 760.48 | 1 | 32 | 1 | 20 | 1 | 48 | 1 | 40 | 1 | 36 | 1 | 20 | | | | |
| 2B | 8.4 | 200 | 1680 | 2 | 64 | | | 2 | 96 | 1 | 40 | | 1 | 36 | | | | | |
| 2C | 9.29 | 36 | 334.44 | | | | | | | | | | | | | | | | |
| 2D | 17.21 | 40 | 688.4 | | | 2 | 40 | | | | | | | | | | | | |
| 3B | 0.55 | 160 | 88 | 1 | 32 | | | 1 | 48 | 1 | 40 | | | 1 | 20 | 1 | 12 | 2 | 8 |
| 3D | 1.36 | 56 | 76.16 | | | 1 | 20 | | | | | | 1 | 36 | | | | | |
| TDS C44 | 0.46 | 4 | 1.84 | | | | | | | | | | | | | | | 1 | 4 |
| TDS C54 | 0.75 | 120 | 90 | 1 | 32 | | | 1 | 48 | 1 | 40 | | | | | | | | |
| TDS C74 | 2.82 | 32 | 90.24 | | | | | | | | | | | 1 | 20 | 1 | 12 | | |
| TDS C75 | 1.63 | 56 | 91.28 | | | 1 | 20 | | | | | | | 1 | 36 | | | | |
| TDS C77 | 1.36 | 60 | 81.6 | | | | | | | | 1 | 40 | | 1 | 20 | | | | |
| TDS C88 | 1.84 | 116 | 213.44 | 1 | 32 | | | 1 | 48 | | | | | 1 | 36 | | | | |
| TDSC1010 | 3 | 20 | 60 | | | 1 | 20 | | | | | | | | | | | | |
| A36 R4x16" | 1.44 | 4 | 5.76 | | | | | | | | | | | | | | | 1 | 4 |

Level 3 (R) 5230 #
 Level 2 (R) 8180 #
 Level 1 (L) 15230 #

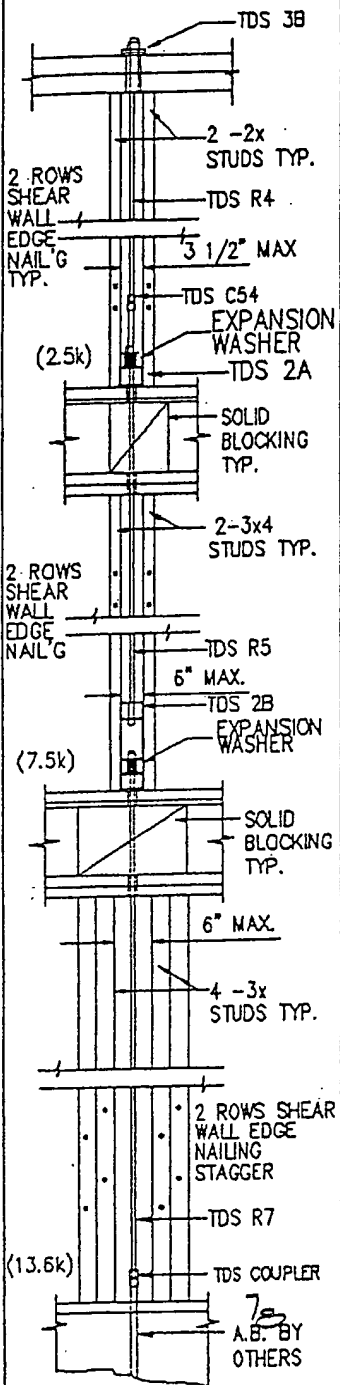


A.B.'S PER STRUCTURAL DWGS. TYP.

3B 2A 2B (457)

4

Level 3 (R) 8180 #
 Level 2 (ST) 12570 #
 Level 1 (R) 20940 #

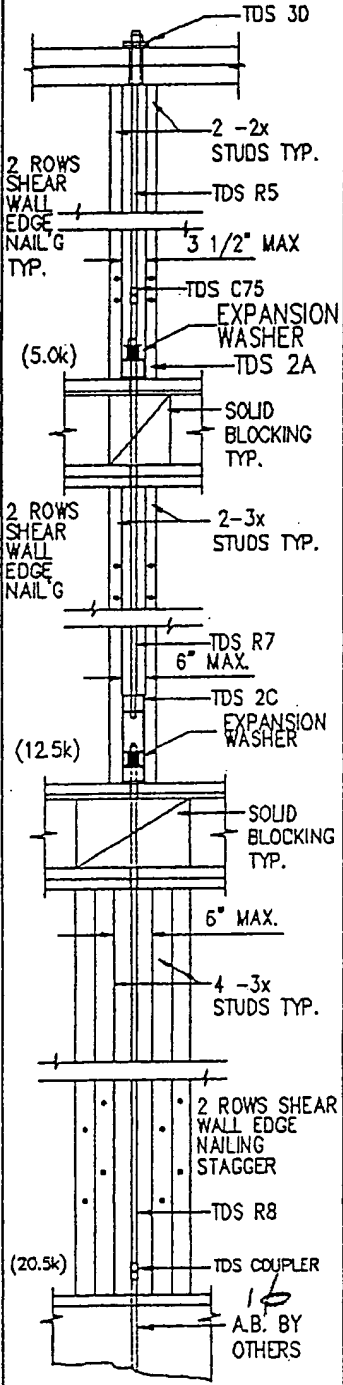


A.B.'S PER STRUCTURAL DWGS. TYP.

3D 2A 2C (578)

5

Level 2 (R) 5230 #
 Level 1 (R) 5230 #

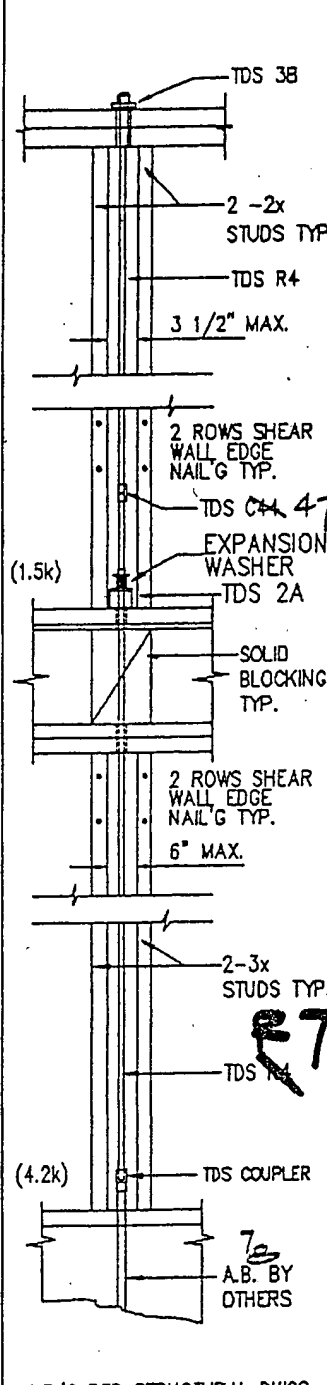


A.B.'S PER STRUCTURAL DWGS.

3B 2A

6

Level 1 (R) 5230 #

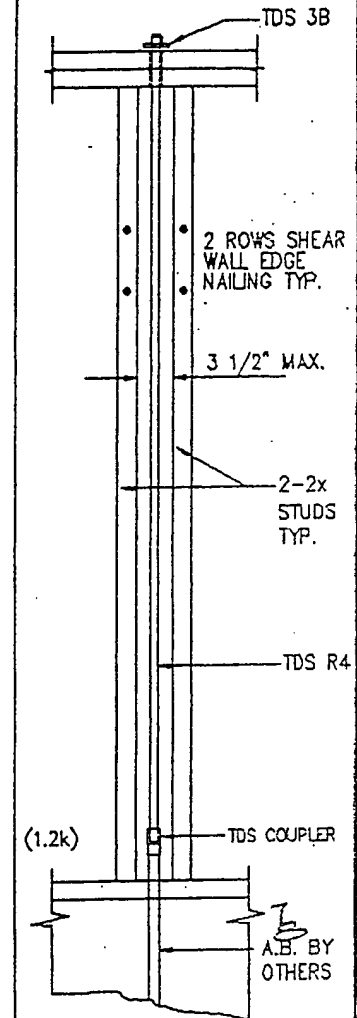


A.B.'S PER STRUCTURAL DWGS.

3B (4)

7


ADD TO REV CALLS FOR THIS → REIN. PARTS

Level 4 (RODS) 1' #
 Level 3 (RODS) 16' #
 Level 2 (L) 30460 #
 Level 1 (STUDS) 36090 #

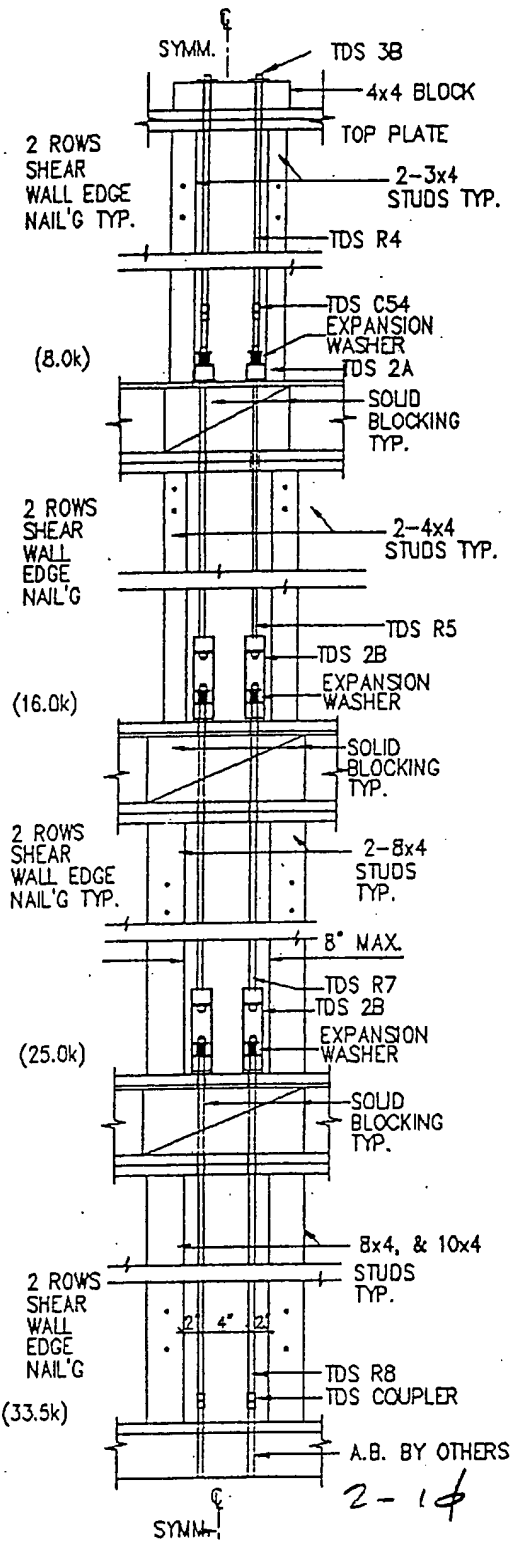


3B 2A 2B 2B (4578)

3B 2A 2B 2B (4578)

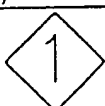


Level 4 (R) #
 Level 3 (L) #
 Level 2 (L) 23450 #
 Level 1 (ST) 31710 #

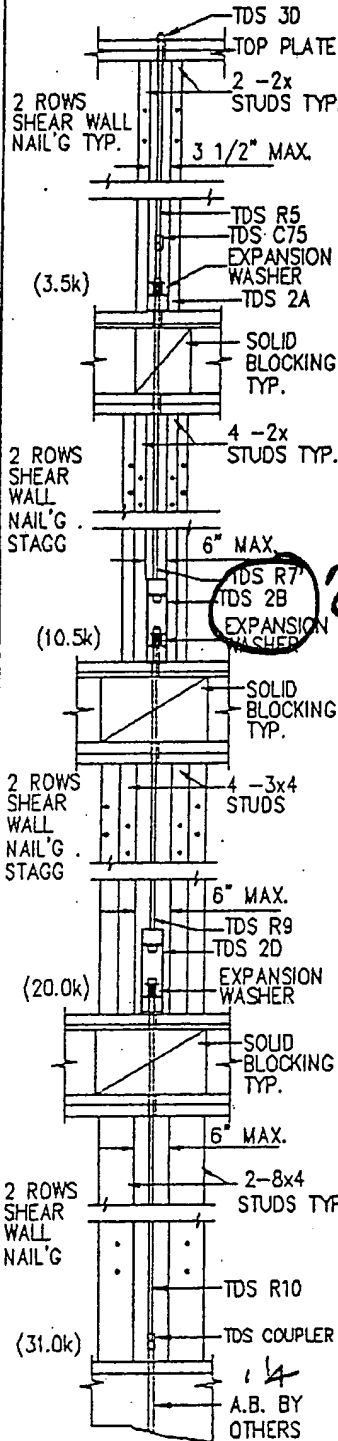


A.B.'S PER STRUCTURAL DWGS.

3D 2A 2D 2D (5,7,9,10)

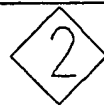

Level 4 (R) 5230 #
 Level 3 (R) 8180 #
 Level 2 (L) 15230 #
 Level 1 (R) 20940 #

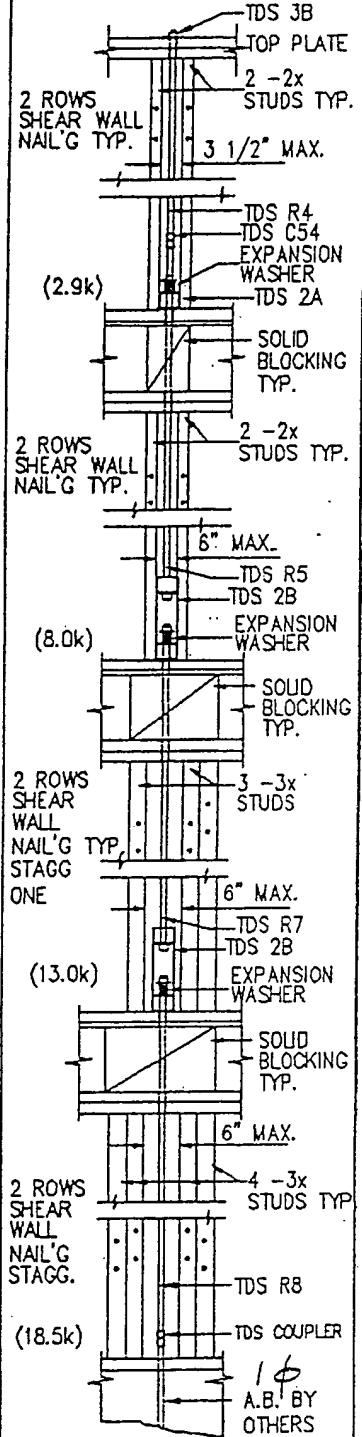


A.B.'S PER STRUCTURAL DWGS.

3B 2A 2B 2B (4578)



S. SAN FRANCISCO

Calculations Table

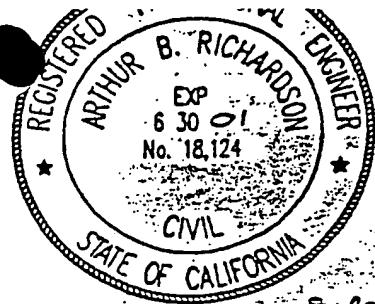PROJECT NO. 98122PROJECT NAME SHERATON INN

8.20.98

| LEVEL | TDS MODEL | TDS VALUE | TDS ROD | Σ TDS ± VAL | FRAME VALUE | CONTR VALUE | HD VALUE | HD | |
|-------|-----------|-----------|---------|----------------|----------------|----------------|-------------|----|--------------------------|
| 4TH | 2x3A | 11.26 | | | | | | | (DBL 3) |
| | 2x2A | | 10.46 | | | 10.46 | 8.00 | | |
| | 1-3x4 | | | | 12.57 | | | | |
| 3RD | 2x2A | 12.20 | | 22.66 | | | | | 1 |
| | 2x2B | | 16.36 | | | 16.36 | 16.00 | | |
| | 2x4x4 | | | | 16.95 | | | | |
| 2ND | 2x2B | 14.10 | | 30.46 | | 30.46 | | | DBL [3A2A2B2B (4578) |
| | 2x27 | | 32.06 | | | | 25.00 | | |
| | 1-2x4 | | | | 31.71 | | | | |
| 1ST | 2x2B | 14.10 | | 44.56 | | | | | |
| | 2x2B | | 41.88 | | | | 33.50 | | |
| | 8x4x10x4 | | | | 36.09 | 36.09 | | | |
| 4TH | 3D | 10.35 | | | | | | | 2 |
| | 25 | | 8.18 | | | 8.18 | 3.50 | | |
| | 2-2x4 | | | | 8.20 | | | | |
| 3RD | 2A | 6.10 | | 14.28 | | 14.28 | | | 3D2A2D2D (57910) |
| | 27 | | 16.03 | | | | 10.50 | | |
| | 1-2x4 | | | | 14.76 | | | | |
| 2ND | 2D | 9.17 | | 23.45 | | 23.45 | | | |
| | 29 | | 26.50 | | | | 20.00 | | |
| | 4-3x4 | | | | 23.51 | | | | |
| 1ST | 2D | 9.17 | | 32.62 | | | | | |
| | 26 | | 32.72 | | | | 31.00 | | |
| | 2-2x4 | | | | 31.71 | 31.71 | | | |
| 4TH | 3D | 5.63 | | | | | | | |
| | 2A | | 5.23 | | | 5.23 | 2.90 | | |
| | 2-2x4 | | | | 8.20 | | | | |
| 3RD | 2A | 6.10 | | 11.33 | | | | | 3A2A2A2A (4578) |
| | 25 | | 8.18 | | | 8.18 | 8.00 | | |
| | 2-2x4 | | | | 8.20 | | | | |
| 2ND | 2D | 7.05 | | 15.23 | | 15.23 | | | |
| | 27 | | 16.03 | | | | 13.00 | | |
| | 3-3x4 | | | | 18.04 | | | | |
| 1ST | 2D | 7.05 | | 22.28 | | | | | |
| | 2B | | 20.94 | | | 20.94 | 18.5 | | |
| | 1-3x4 | | | | 23.51 | | | | |
| 3RD | 3D | 5.63 | | | | | | | |
| | 2A | | 5.23 | | | 5.23 | 2.50 | | |
| | 2-2x4 | | | | 8.20 | | | | |
| 2ND | 2A | 6.10 | | 11.33 | | | | | 3A2A2A (457) |
| | 25 | | 8.18 | | | 8.18 | 7.50 | | |
| | 2-3x4 | | | | 12.57 | | | | |
| 1ST | 2D | 7.05 | | 15.23 | | 15.23 | | | |
| | 27 | | 16.03 | | | | 13.60 | | |
| | 4-3x4 | | | | 23.51 | | | | |

6.6
12.7
21.8

**This Page is Inserted by IFW Indexing and Scanning
Operations and is not part of the Official Record**

BEST AVAILABLE IMAGES

Defective images within this document are accurate representations of the original documents submitted by the applicant.

Defects in the images include but are not limited to the items checked:

- ☒ **BLACK BORDERS**
- ☒ **IMAGE CUT OFF AT TOP, BOTTOM OR SIDES**
- ☒ **FADED TEXT OR DRAWING**
- ☒ **BLURRED OR ILLEGIBLE TEXT OR DRAWING**
- ☒ **SKEWED/SLANTED IMAGES**
- ☐ **COLOR OR BLACK AND WHITE PHOTOGRAPHS**
- ☐ **GRAY SCALE DOCUMENTS**
- ☒ **LINES OR MARKS ON ORIGINAL DOCUMENT**
- ☐ **REFERENCE(S) OR EXHIBIT(S) SUBMITTED ARE POOR QUALITY**
- ☐ **OTHER:** _____

IMAGES ARE BEST AVAILABLE COPY.

As rescanning these documents will not correct the image problems checked, please do not report these problems to the IFW Image Problem Mailbox.